


Level 1 - DD
1/8" = 1'-0"

SEE ENLARGED PLANS FOR
ADDITIONAL LAYOUT DIMENSIONS
AND PARTITION TYPES.

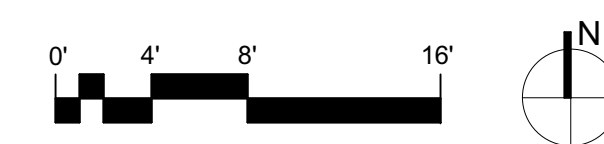

- NOTES ABOUT DIMENSIONING**
- Dimensions to interior partitions are to finished face or centerline of partition type exclusive of applied thin finish (e.g., tile) or to face of thick finish (e.g., w/d paneling) as shown UNO.
 - Clear dimensions indicate a minimum clear dimension, inclusive of applied finish, as required.
 - Dimensions of masonry elements are true (not nominal) dimensions.
 - Door jams shown near return walls are located 4" from return wall UNO.
 - Dimensions to window jams are to exterior masonry openings UNO.
 - GM is to confirm all dimensions in the field and notify Architect of any proposed deviation from dimensions shown.
 - Partitions shown centered on column CL are to be centered on column CL UNO.
 - Partitions shown offset from columns are located per typical column enclosure detail UNO.
 - Partitions shown centered on window mullions are to be centered on the window mullion UNO.

- NOTES ON CONSTRUCTION**
- Where the break between floor materials is not shown on plan, locate the break at the door in accordance with the appropriate floor transition detail UNO.
 - See G1.03 AND G1.04 LIFE SAFETY FLOOR PLANS for location of fire and smoke rated partitions.
 - Where a partition type is called out for one side only of a shaft, the same type shall apply to all sides.
 - Wall shaded pink denote acoustic partitions, see Sheet G1.10 WALL TYPE SCHEDULE for more information on partitions.
 - Refer to Sheet G1.40 FINISH SCHEDULE AND LEGENDS for more information on ceiling finishes.

SPECIALTY EQUIP		
TYPE	DESCRIPTION	Keynote
AED	AED CABINET	BY OWNER
BKE	BIKE RACK	12 93 15
FEC	FIRE EXTINGUISHER CABINET	10 44 00
KNOX	KNOX BOX	10 41 00
LCKR	METAL LOCKERS	10 51 10
NLX	NALC/BOX	BY OWNER
WTP	WALL TERMINATION PROFILE	092110

REVISION SCHEDULE		
#	DATE	REVISION DESCRIPTION
1	07.05.2022	Addendum 1
4	7.15.2022	Bulletin 1
5	8.10.2022	Bulletin 2
7	10.07.2022	Bulletin 4
9	11.18.2022	Bulletin 6
10	01.06.2023	Bulletin 7
11	01.24.2023	Bulletin 8
12	02.17.2023	Bulletin 9
13	05.02.2023	Bulletin 10
14	06.24.2023	Bulletin 11

PROJECT NAME:

CML REYNOLDSBURG
1402 BRICE ROAD
REYNOLDSBURG, OHIO 43068

100% CONSTRUCTION DOCUMENTS
ISSUED FOR BIDDING AND PERMIT

ISSUE DATE: 02 10 2023

Jonathan Barnes
Architecture and Design
243 N 5th Street, Suite 200
Columbus, OH 43215
614.228.7311
www.jbab.com

EXP. 12-31-2022

LEVEL 1 FLOOR PLAN

A1.01